


Length from K2 Laser enclosure on EL-Ring to AO (left Nas)


fiber for NGAO lasers

measurements taken 19July2010 JC/EW


| relevant photos | segment on DWG | From | To | Inch | Millimeter | Comment | Inch | Millimeter | Comment |
|-----------------|----------------|------------------------------|------------------------------|-------|-----------------|---|-------|-----------------|---|
| 1 | A | Laser Head | Laser Enclosure wall (exit) | 215.0 | 5461.00 | Measurement | 172.0 | 4368.80 | optimize enclosure routing; reduce by 20% |
| 2 | B | Laser Enclosure wall (exit) | Elevation Center Ring Corner | 27.0 | 685.80 | Measurement/Calculation; confirmed on model (650mm) | 27.0 | 685.80 | |
| 2,3,4 | C | Elevation Center Ring Corner | Elevation Top Ring Corner | 268.0 | 6807.20 | Measurement, confirmed on Medwadowski dwg 2.1 & model (6784mm) | 268.0 | 6807.20 | |
| 5,6 | D | Elevation Top Ring Corner | Elevation Divot | 17.0 | 433.00 | Drawing (Medwadowski 2.2) & model | 17.0 | 433.00 | |
| 5,6 | E | Elevation Divot | Elevation Top Center Corner | 123.0 | 3123.30 | Medwadowski dwg 2.2 & Solidworks model; confirmed by measurement (122" = 3099mm) | 118.3 | 3006.00 | |
| 7 | F | Elevation Top Center Corner | Cable Tray 1 End | 64.0 | 1625.60 | Measurement | 64.0 | 1625.60 | |
| 8,9 | G | Cable Tray 1 End | Cable Wrap Exit | 36.0 | 914.40 | Measurement | 36.0 | 914.40 | |
| 10,11 | H | Cable Wrap Exit | Cable Wrap Entrance | 384.0 | 9753.60 | Measurement (perhaps 360mm long, outside vs center), confirmed on Kockums KE02000 & KE02030 (9749 mm) | 345.9 | 8785.86 | calculate distance for center of tray (369.9"); don't go to floor, shorten by 24" |
| 11 | I | Cable Wrap Entrance | AOE side wall 1 | 21.0 | 533.40 | Measurement | 21.0 | 533.40 | |
| 11 | J | AOE side wall 1 | AOE side wall 2 | 22.0 | 558.80 | Measurement; confirmed on WKMO 1300-C008 | 22.0 | 558.80 | |
| 12 | K | AOE side wall 2 | AOE side wall 3 | 36.0 | 914.40 | Measurement | 36.0 | 914.40 | |
| 12,13,14 | L | AOE side wall 3 | AOE cable tray vertical | 102.0 | 2590.80 | Measurement | 78.0 | 1981.20 | don't go to floor, shortens by 24" |
| | M | AOE cable tray vertical | AOE cable tray Horizontal | 128.0 | 3251.20 | Measurement | 70.0 | 1778.00 | position racks closer to wrap (inside AO) |
| | N | AOE cable tray Horizontal | AOE cable tray down | 99.0 | 2514.60 | Measurement | 65.9 | 1674.72 | don't go to floor |
| | | | | | | | | | |
| | | | | | | | | | |
| | | | Total distance | | 39167.10 | | | 34067.18 | |

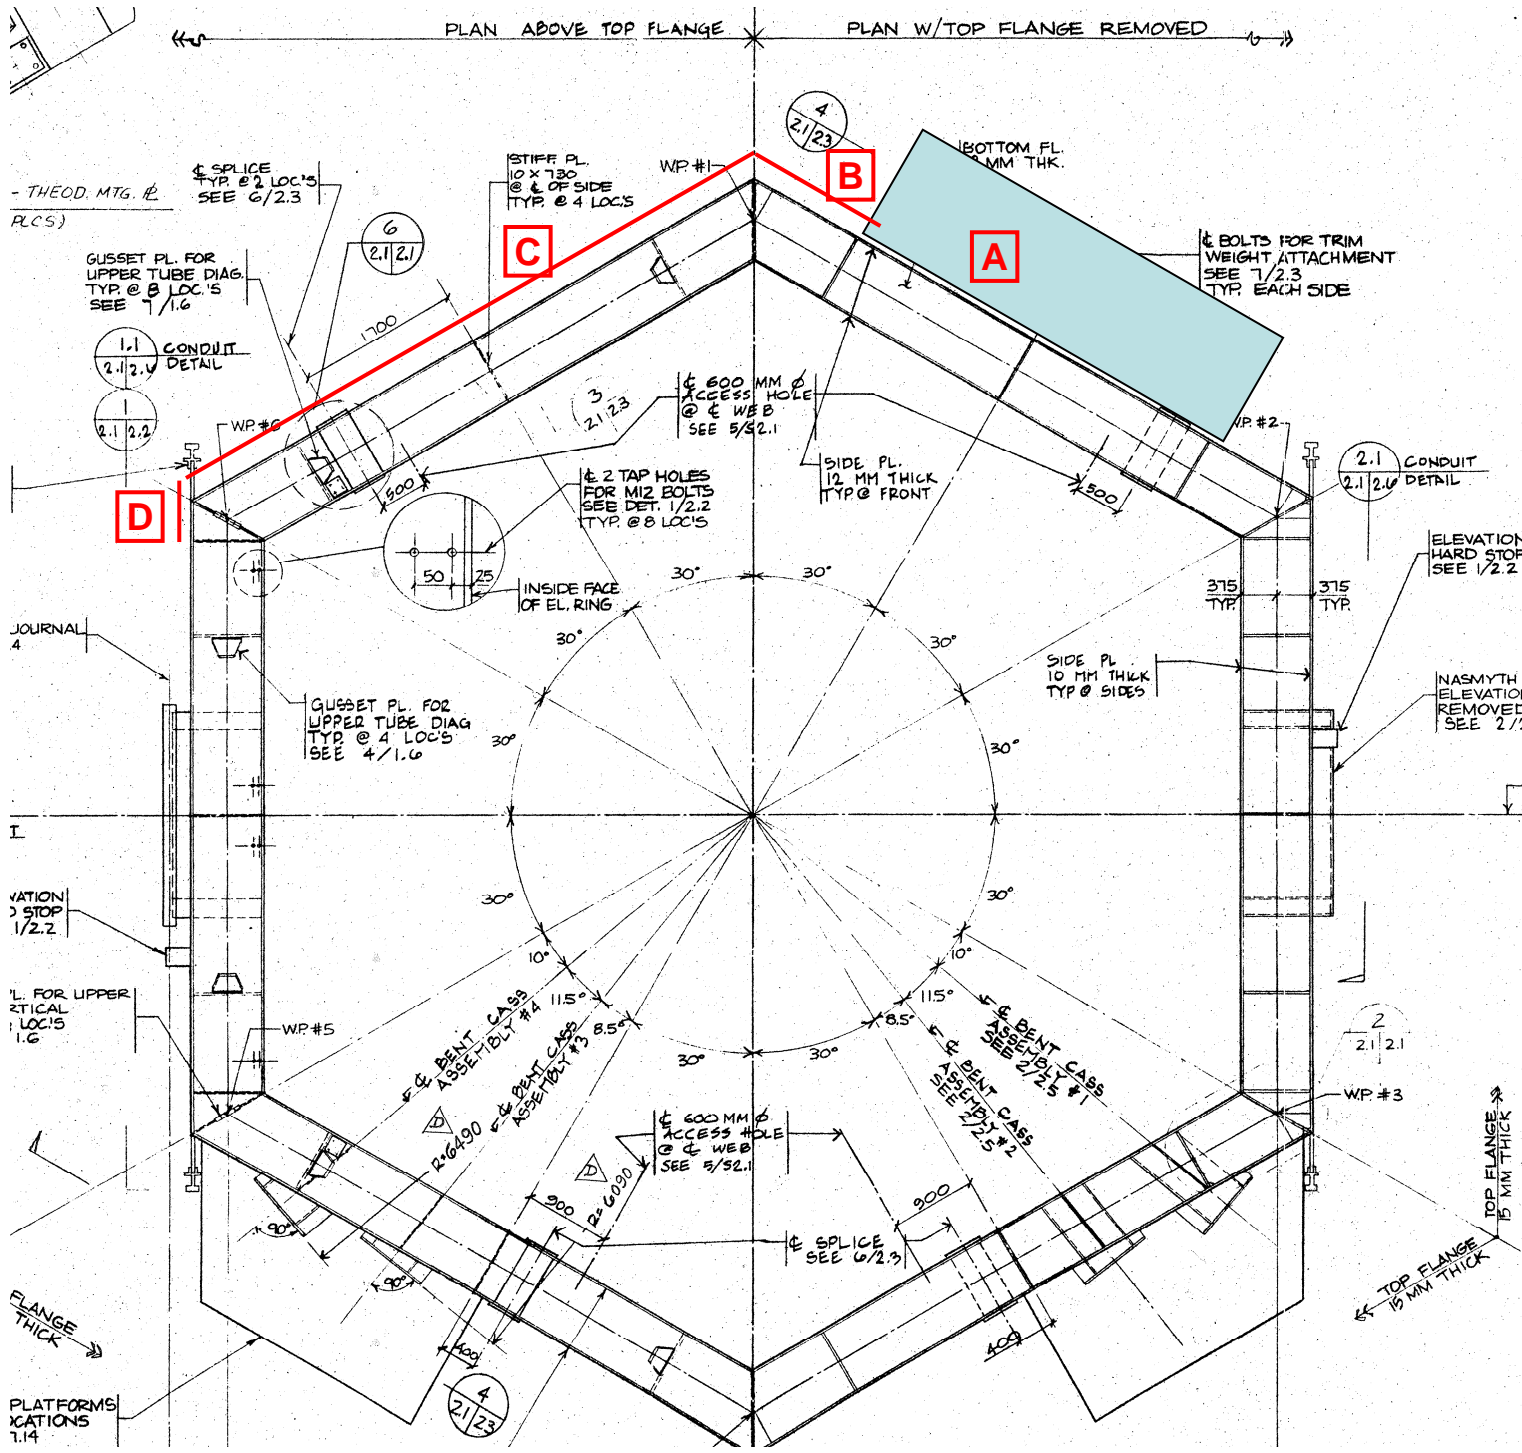

TYP. 3.2
 2.1, 2.2

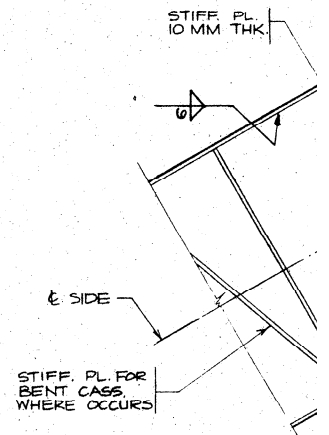



2 ENLARGED P
 2.1, 2.1

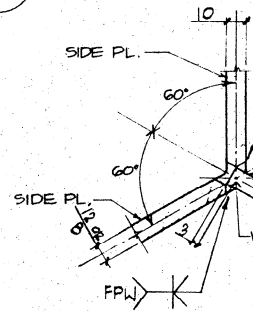


CORNER VERT. STIFF PL

3 WELD DETAIL
 2.1, 2.1

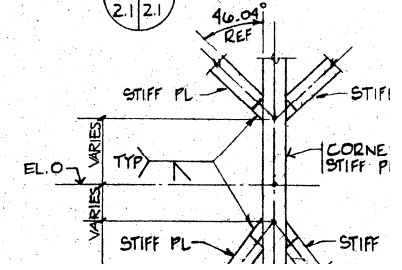

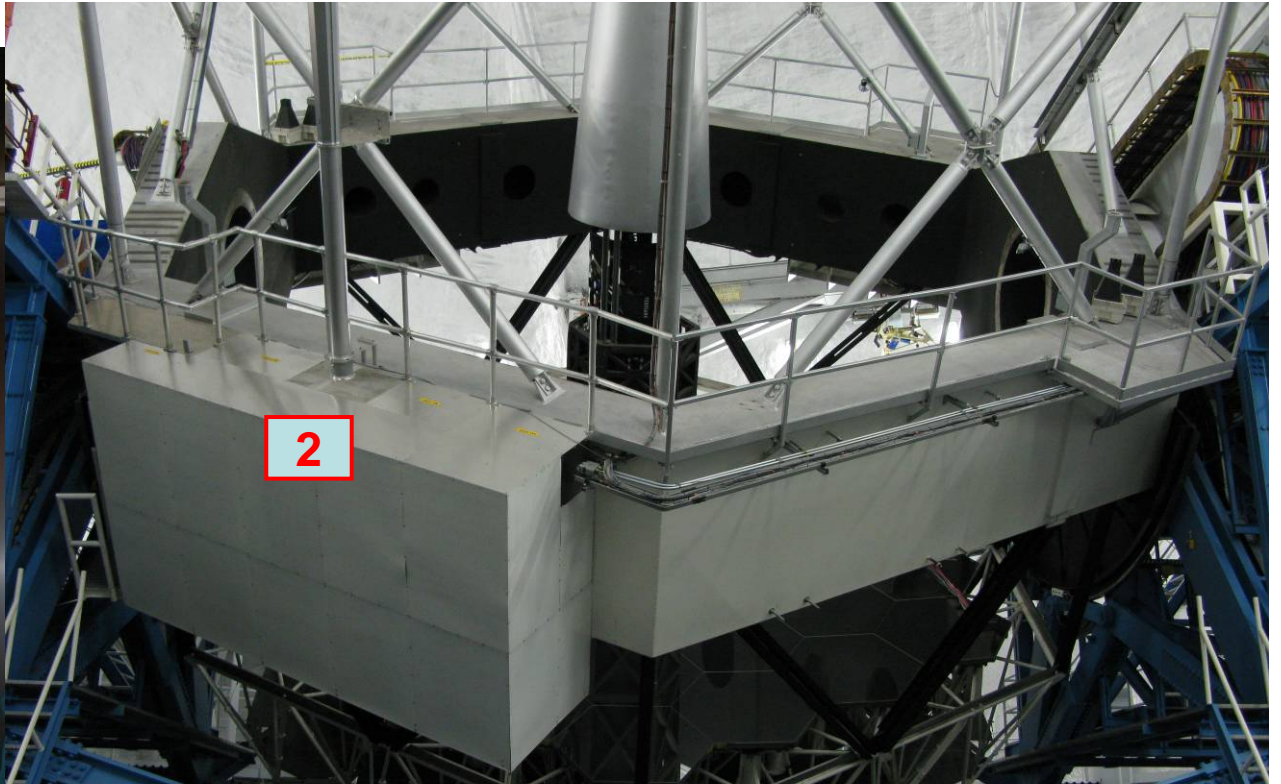

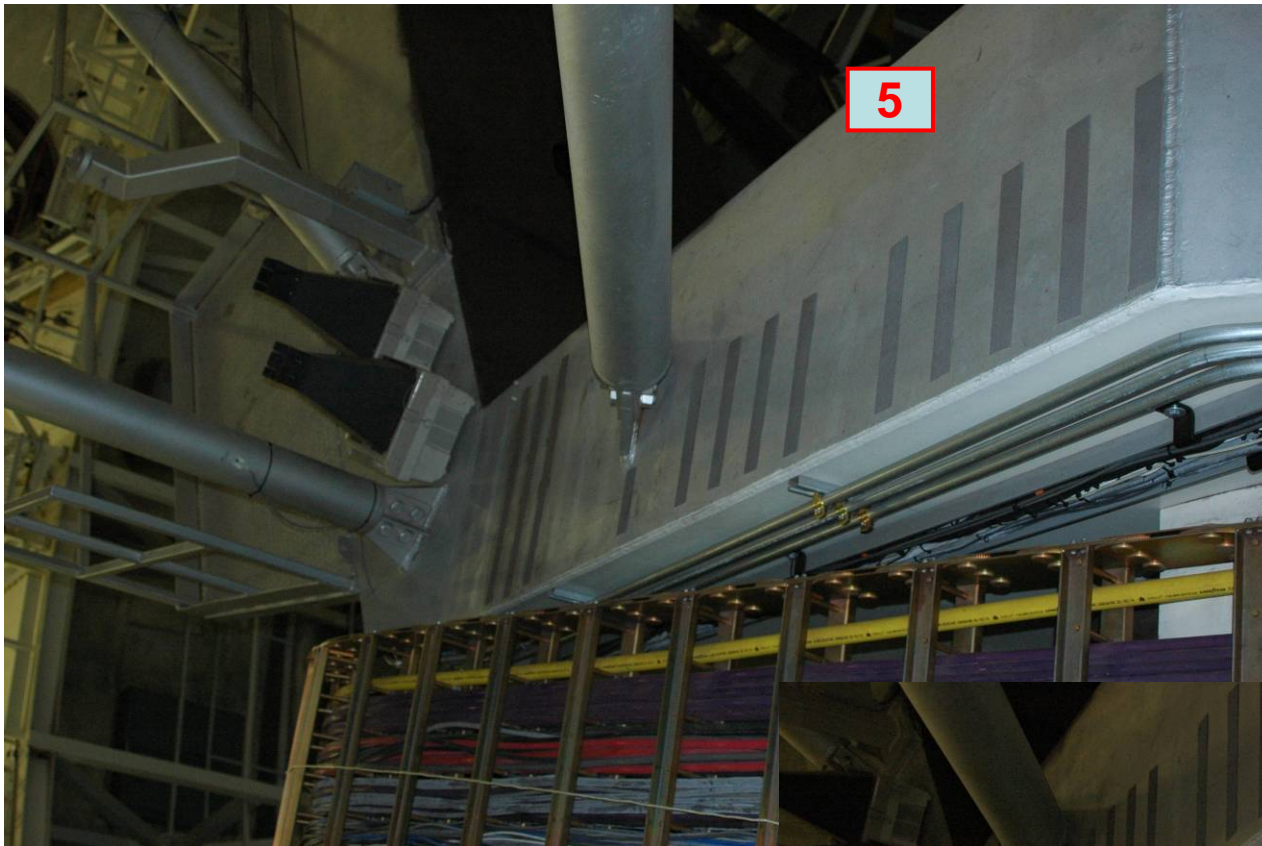




NOTES (UNLESS OTHERWISE SPECIFIED)

H

| REV | DESCRIPTION | BY | CHK | DATE |
|-----|--|-----|-----|---------|
| A | CHAMBERLAIN SUPPORT LOCATION AND WHEEL TRACK SPACING | MPS | MPS | 10/2/92 |

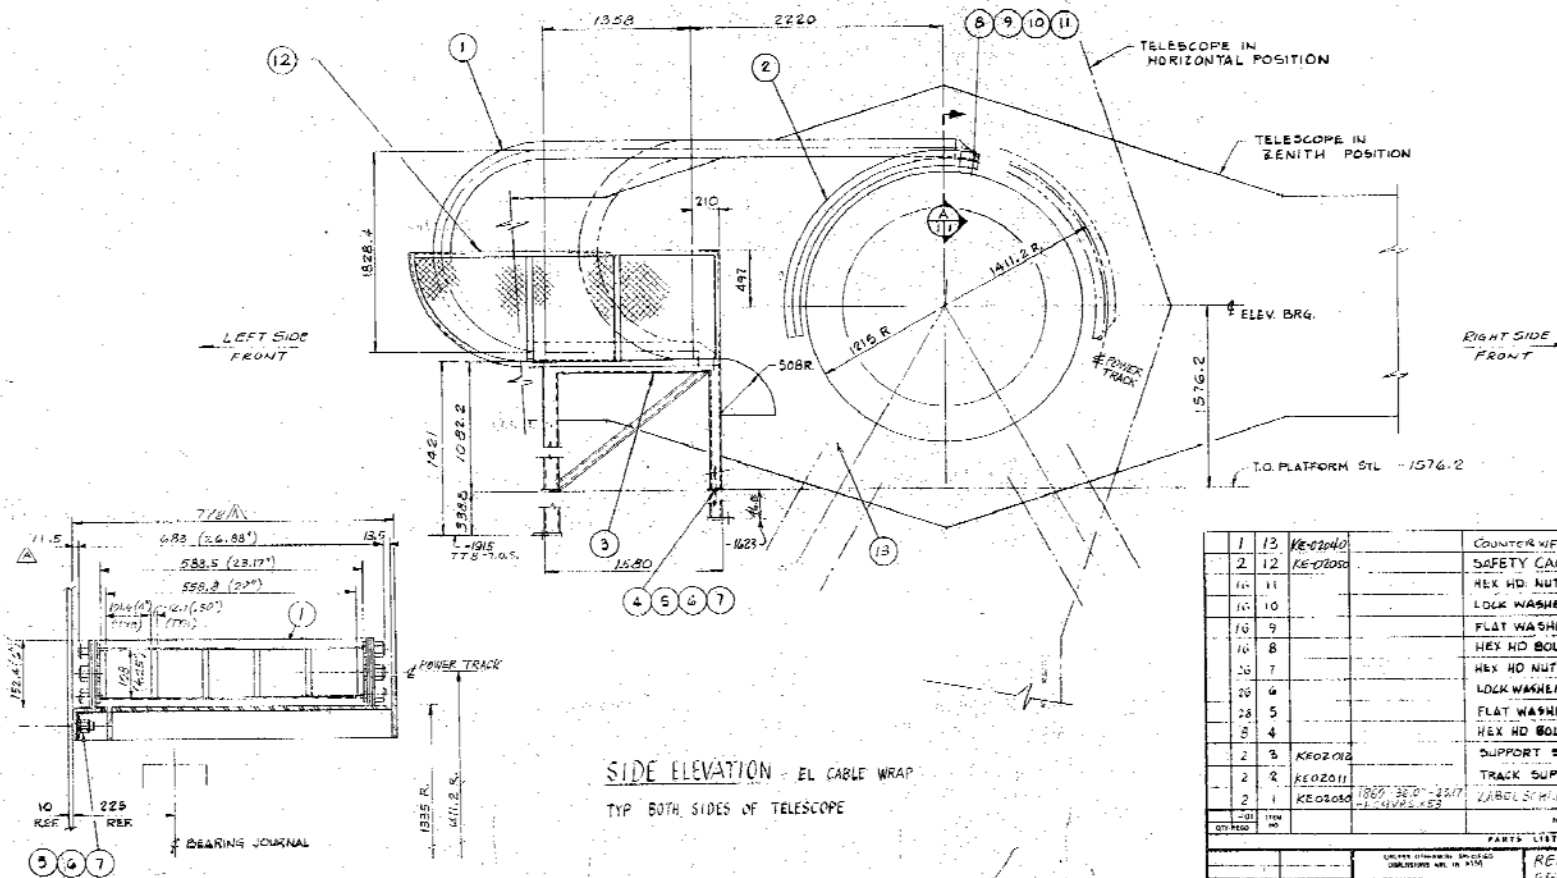

| QTY | ITEM NO | DESCRIPTION | MATERIAL |
|-----|---------|------------------|--------------------------------|
| 1 | 13 | KE-02040 | COUNTERWEIGHTS & FASTENERS |
| 2 | 12 | KE-02050 | SAFETY CAGE |
| 10 | 11 | | HEX HD NUT 1/2-13 UNC |
| 10 | 10 | | LOCK WASHER 1/2" SPRING |
| 10 | 9 | | FLAT WASHER 1/2" |
| 10 | 8 | | HEX HD BOLT 1/2-13 UNC X 2 1/4 |
| 10 | 7 | | HEX HD NUT 3/4-10 UNC |
| 10 | 6 | | LOCK WASHER 3/4" SPRING |
| 10 | 5 | | FLAT WASHER 3/4" |
| 10 | 4 | | HEX HD BOLT 3/4-10 UNC X 2 1/4 |
| 2 | 3 | KE-02018 | SUPPORT STAND |
| 2 | 2 | KE-02011 | TRACK SUPPORT |
| 2 | 1 | KE-02030 | LABELS: SCHLUPP POWER TRACK |
| 1 | 1 | 1800 380" - 220" | LANDER |

| | | | | | |
|-------------|--|--|--|--|--|
| -01 ITEM NO | | NOMENCLATURE OF DESCRIPTION | | MATERIAL OR UNIT | |
| QTY REQD | | PARTS LIST | | | |
| | | CARRIER (STANDARD) SPECIFIED COMPRESSION AIR IN ITEM | | REF: 197-02-00 REV C REF: 197-02-00 REV A | |
| | | 10 FRANCES SECTIONAL S X 1/2 X 1/4 X 1/8 X 1/16 X 1/32 X 1/64 X 1/128 X 1/256 X 1/512 X 1/1024 X 1/2048 X 1/4096 X 1/8192 X 1/16384 X 1/32768 X 1/65536 X 1/131072 X 1/262144 X 1/524288 X 1/1048576 X 1/2097152 X 1/4194304 X 1/8388608 X 1/16777216 X 1/33554432 X 1/67108864 X 1/134217728 X 1/268435456 X 1/536870912 X 1/1073741824 X 1/2147483648 X 1/4294967296 X 1/8589934592 X 1/17179869184 X 1/34359738368 X 1/68719476736 X 1/137438953472 X 1/274877906944 X 1/549755813888 X 1/1099511627776 X 1/2199023255552 X 1/4398046511104 X 1/8796093022208 X 1/17592186044416 X 1/35184372088832 X 1/70371252455336267171595264 X 1/140742504903657293676544 X 1/281485009807314587353088 X 1/562970019642690137372762112 X 1/1125940039285380274745524224 X 1/2251880078570760549491048448 X 1/4503760157141521098982096896 X 1/9007520314283042197964193792 X 1/1801504062856608439592838784 X 1/3603008125713216879185677568 X 1/7206016251426433758371355136 X 1/14412032502852867516742710272 X 1/28824065005705735033485420544 X 1/57648130011411470066970841088 X 1/115296260022822940133941762176 X 1/230592520045645880267883524352 X 1/461185040091291760535767048704 X 1/922370080182583521071534097408 X 1/184474016365167042143068194816 X 1/368948032730334084286136389632 X 1/73789606546068168572272779264 X 1/147579212913213701601985367484928 X 1/295158425826426403203970734969856 X 1/590316851652532806407941469939712 X 1/1180633703254665612815882939879424 X 1/2361267406509331225631765879758848 X 1/47225348130186624512635304201501200704 X 1/94450696260373249025268608403024001408 X 1/188901385120746480505373216806048002816 X 1/377802770241492961010746433612096005632 X 1/755605540482985922021492867241920011264 X 1/151121108976597184404396534483840022528 X 1/302242217953194368808793068967680045056 X 1/604484435806388737617576137935360090112 X 1/120896887161377475435151267470720180224 X 1/241793774322754950870302534941440360448 X 1/483587548645509901740605069882880720896 X 1/967175097291019803481210139765761441792 X 1/19343501958203960069624202793152883584 X 1/38687003916407920139248405586305767168 X 1/77374007832815840278496811172611534336 X 1/15474801566563168056993732345223068672 X 1/30949603133126336113987464690446137344 X 1/61899206266252672227974929380886274688 X 1/123798412532515344555598958761735360090112 X 1/2475968250650306891111979175270720180224 X 1/4951936501300613782223958350541440360448 X 1/9903873002601227564447916701082880720896 X 1/19807746053022451128889833402165761441792 X 1/3961549210604490225777966680433152883584 X 1/7923098421208980451555933360866305767168 X 1/15846196842417960911119666721732611534336 X 1/3169239368483592182223933344345223068672 X 1/6338478736967184364447866688690446137344 X 1/1267695747333436872889773377380886274688 X 1/2535391494666873745779546754761732611534336 X 1/507078298933374749155909350952345223068672 X 1/101415659786674948231181807010446137344 X 1/202831319573349896462363614020886274688 X 1/405662639146699792924727228041732611534336 X 1/81132527829339958584945445608346137344 X 1/16226505765867991716989089121686274688 X 1/32453011531735983433978178243372611534336 X 1/64906023063471966867956356486745223068672 X 1/12981204612694393373591271369386274688 X 1/25962409225388786747182542738772611534336 X 1/51924818450777573494365085477545223068672 X 1/1038496370015514698887301709552345223068672 X 1/207699274003102939777460341910446137344 X 1/415398548006205879554920683820886274688 X 1/830797096012411759109940137741732611534336 X 1/166159419202422351821998027542345223068672 X 1/332318838404844703643996055084690446137344 X 1/664637676809689407287992110169380886274688 X 1/1329275353619378814575984220338772611534336 X 1/2658550707238757629151968440677545223068672 X 1/53171014144775152583039368813552345223068672 X 1/10634202828955030516607873762710446137344 X 1/21268405657910061033215747525420886274688 X 1/42536811315820122066431495050841732611534336 X 1/8507362263164024413286299010169380886274688 X 1/17014724526328048826572598020338772611534336 X 1/34029449052656097653145196040677545223068672 X 1/680588981053121953062903920813552345223068672 X 1/136117796210624390612578740167072611534336 X 1/2722355924212487812251574803341732611534336 X 1/544471184842497562450314960668345223068672 X 1/1088942369684995124900629921336772611534336 X 1/217788473936999024980125984267545223068672 X 1/4355769478739980499602519685350886274688 X 1/8711538957479960999205039370701732611534336 X 1/17423079114959921998410078741403380886274688 X 1/34846158229919843996820157482806772611534336 X 1/69692316459839687993640314965613552345223068672 X 1/13938463291967937598728062971126772611534336 X 1/278769265839358751974561259422545223068672 X 1/5575385316787175039491225188450886274688 X 1/1115077063357435007898245037701732611534336 X 1/2230154126714870015796490075403380886274688 X 1/4460308253429740031592980150806772611534336 X 1/8920616506859480063185960301613552345223068672 X 1/17841233013718960126371920603227072611534336 X 1/356824660274379202527438412064545223068672 X 1/7136493205487584050548768241290886274688 X 1/14272984010975168101097536482581732611534336 X 1/28545968021950336202195072965163552345223068672 X 1/57091936043900672404390145930327072611534336 X 1/114183872087801348008780291660545223068672 X 1/2283677441756026960175605833210886274688 X 1/4567354883512053920351211666421732611534336 X 1/9134709767024107840702423332843552345223068672 X 1/18269419534048215681404846665687072611534336 X 1/365388390680964313628096933313745223068672 X 1/73077678136192862725619386662750886274688 X 1/14615535627238572545123877332551732611534336 X 1/29231071254477145090247754665103552345223068672 X 1/5846214250895429018049550933020886274688 X 1/11692428501790858036099101866041732611534336 X 1/23384857003581716072198203732083552345223068672 X 1/46769714007163432144396407464167072611534336 X 1/935394280143268642887928149283345223068672 X 1/18707885602865372857758562985667072611534336 X 1/374157712057307457155171259713345223068672 X 1/7483154241146149143103425194267072611534336 X 1/149663084822922982862068503885345223068672 X 1/29932616964584596572413700777067072611534336 X 1/5986523392916919314482740155413552345223068672 X 1/11973046785833838628965480310827072611534336 X 1/239460935716676772579309606216545223068672 X 1/4789218714333535451586192124330886274688 X 1/9578437428667070903172384248661732611534336 X 1/19156874857334141806344768497327072611534336 X 1/383137497146682836126895369946545223068672 X 1/7662749942933656722537907398930886274688 X 1/15325499884667313445075814797861732611534336 X 1/30650999769334626890151629595723552345223068672 X 1/6130199953866925378030325919144652345223068672 X 1/12260399907733850756060651838290886274688 X 1/24520799815467701512121303676581732611534336 X 1/49041599630935403024242607353163552345223068672 X 1/98083199261870806048485214706327072611534336 X 1/19616639852374161209697042941263552345223068672 X 1/39233279704748322419394085882527072611534336 X 1/784665594094966448387881717650545223068672 X 1/15693311881899328967757634353010886274688 X 1/31386623763798657935515268706021732611534336 X 1/62773247527597315871030537412043552345223068672 X 1/1255464950551946317420610748240886274688 X 1/2510929901103892634841221496481732611534336 X 1/502185980220778526968244299296345223068672 X 1/10043719604415570539364885985927072611534336 X 1/200874392088311410787297719718545223068672 X 1/4017487841766228215745954394370886274688 X 1/8034975683532456431491908788741732611534336 X 1/16069951367064912862983817577483552345223068672 X 1/32139902734129825725967635154967072611534336 X 1/642798054682596514519352703099345223068672 X 1/12855961093651930290387054061986886274688 X 1/257119221873038605807741081239345223068672 X 1/5142384437460772116154821624786886274688 X 1/10284768874921544232309642449573552345223068672 X 1/2056953774984308846461928489914652345223068672 X 1/41139075499686176929238569798290886274688 X 1/82278150999372353858477139596581732611534336 X 1/16455630199874470771695427919363552345223068672 X 1/32911260399748941543390855838727072611534336 X 1/658225207994978830867817116774545223068672 X 1/13164504159899576617356342335490886274688 X 1/26329008319799153234712684670981732611534336 X 1/52658016639598306469425369341963552345223068672 X 1/105316033279196612938850738683927072611534336 X 1/2106320665583932258777014773678552345223068672 X 1/42126413311678645175540295473570886274688 X 1/84252826623357290351080590947141732611534336 X 1/16850565324671458070216118189423552345223068672 X 1/33701130649342916140432236378847072611534336 X 1/674022612986858322808644727576945223068672 X 1/1348045225937716645617289455153886274688 X 1/26960904518754332912345789102773552345223068672 X 1/53921809037508665824691578205547072611534336 X 1/1078436180750173316493831564110945223068672 X 1/2156872361500346632987663128221886274688 X 1/4313744723000693265975326256443772611534336 X 1/8627489446001386531950652512887545223068672 X 1/172549788920027730639013050257750886274688 X 1/345099577840055461278026100515501732611534336 X 1/69019915568011092255605220103003552345223068672 X 1/138039831136022184511210440206007072611534336 X 1/2760796622720443690224208804120145223068672 X 1/55215932454408873804484176082402886274688 X 1/1104318648888177476089683521648573552345223068672 X 1/2208637297776354952179367043297145223068672 X 1/44172745955527099043587340865942886274688 X 1/8834549191105419808717468173188573552345223068672 X 1/1766909838221083961743493636277145223068672 X 1/35338196764421679234869872725542886274688 X 1/7067639352884335846973974545108573552345223068672 X 1/1413527870576867169394794909021145223068672 X 1/28270557411537343387895898180422886274688 X 1/5654111482307468677579179636084573552345223068672 X 1/113082229646149373551583992721690886274688 X 1/226164459292298747103167985443381732611534336 X 1/452328918584597494206335970886745223068672 X 1/9046578371691949884126719417734886274688 X 1/1809315674338389976825343883546973552345223068672 X 1/3618631348676779953650687767093945223068672 X 1/7237262697353559907301375534187886274688 X 1/1447452539470711981460275106837573552345223068672 X 1/2894905078941423962920550213675145223068672 X 1/57898101578828479258411004273502886274688 X 1/1157962031576569585168220085470573552345223068672 X 1/2315924063153139170336440170941145223068672 X 1/46318481263062783406728803418822886274688 X 1/9263696252612556681345760683764573552345223068672 X 1/1852739250522511336269152136751145223068672 X 1/37054785010450226725383042735022886274688 X 1/7410957002090045345076608547004573552345223068672 X 1/148219140041800906901532170940090886274688 X 1/296438280083601813803064341880181732611534336 X 1/592876560167203627606128683760363552345223068672 X 1/118575312033440725521225736752072611534336 X 1/237150624066881451042451473504145223068672 X 1/4743012481337629020849029470082886274688 X 1/948602496267525804169805894016573552345223068672 X 1/1897204992535051608339611788031145223068672 X 1/37944099850701032166792235760622886274688 X 1/7588819970140206433358447152124573552345223068672 X 1/15177639940280412866716894204251145223068672 X 1/303552798805608257334337884085022886274688 X 1/60710559761121651466867576817004573552345223068672 X 1/1214211195222433029337351536340090886274688 X 1/2428422390444866058674703072680181732611534336 X 1/4856844780889732117349406145360363552345223068672 X 1/971368956177946423469881229072072611534336 X 1/194273791235589284939976258144145223068672 X 1/3885475824711785698799525162882886274688 X 1/777095164942357139759905032576573552345223068672 X 1/1554190329884714279519810065153145223068672 X 1/31083806597694285590396201303062886274688 X 1/6216761319538857118079240260612573552345223068672 X 1/12433522639077714236158480521225145223068672 X 1/248670452781554284723169610424502886274688 X 1/49734090556310856944633922084900573552345223068672 X 1/99468181112621713889267844169801145223068672 X 1/198936362225243427778535688339602288627 | | | |

1. DIMENSIONS IN PARENTHESIS ARE IN MILLIMETERS.

2. PURCHASE FROM: (SEE NOTE 3)
GLEASON REEL

GLEASON REEL

P.O. BOX 26, 600 S. CLARK ST.

MAYVILLE, WISCONSIN, 53050

(44) 387-4120



MODEL NO = PT6018-W44-30.0"-24"

3. REPLACE WITH :

KABELSCHLEPP (V. "LANDEL")

*VARITRAK® SERIES 93

MODEL NO : 18606
QTY : 53 LINKS

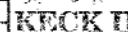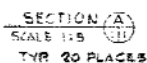

Calculated outside distance @ zenith

(exit to entrance at floor)

$$(1411.3 + 76.2) * \pi / 2 = 2336.6$$

1359

$$(914.4 + 76.2) \cdot \pi = 3112 \text{ (add 76.2 to outside)}$$

1359

210 (tray end to exit radius)

$$508 * \pi / 2 = 798 \text{ (exit radius)}$$

1082.2 – 508 (end of exit radius to floor)


total = 9748.8mm

AS BUILT


APPROVE
DATE:

SOURCE CONTROL DRAWING

| | | | | | |
|--|------|----------|----------------|----------------------------|-----------------|
| NO. 1 | DATE | REF. NO. | CONFIRMING NO. | TERMINALITY OR DESCRIPTION | REMARKS OR NOTE |
| PARTS LIST | | | | | |
| TOWER 17-18-19-20-2685-268 | | | | | |

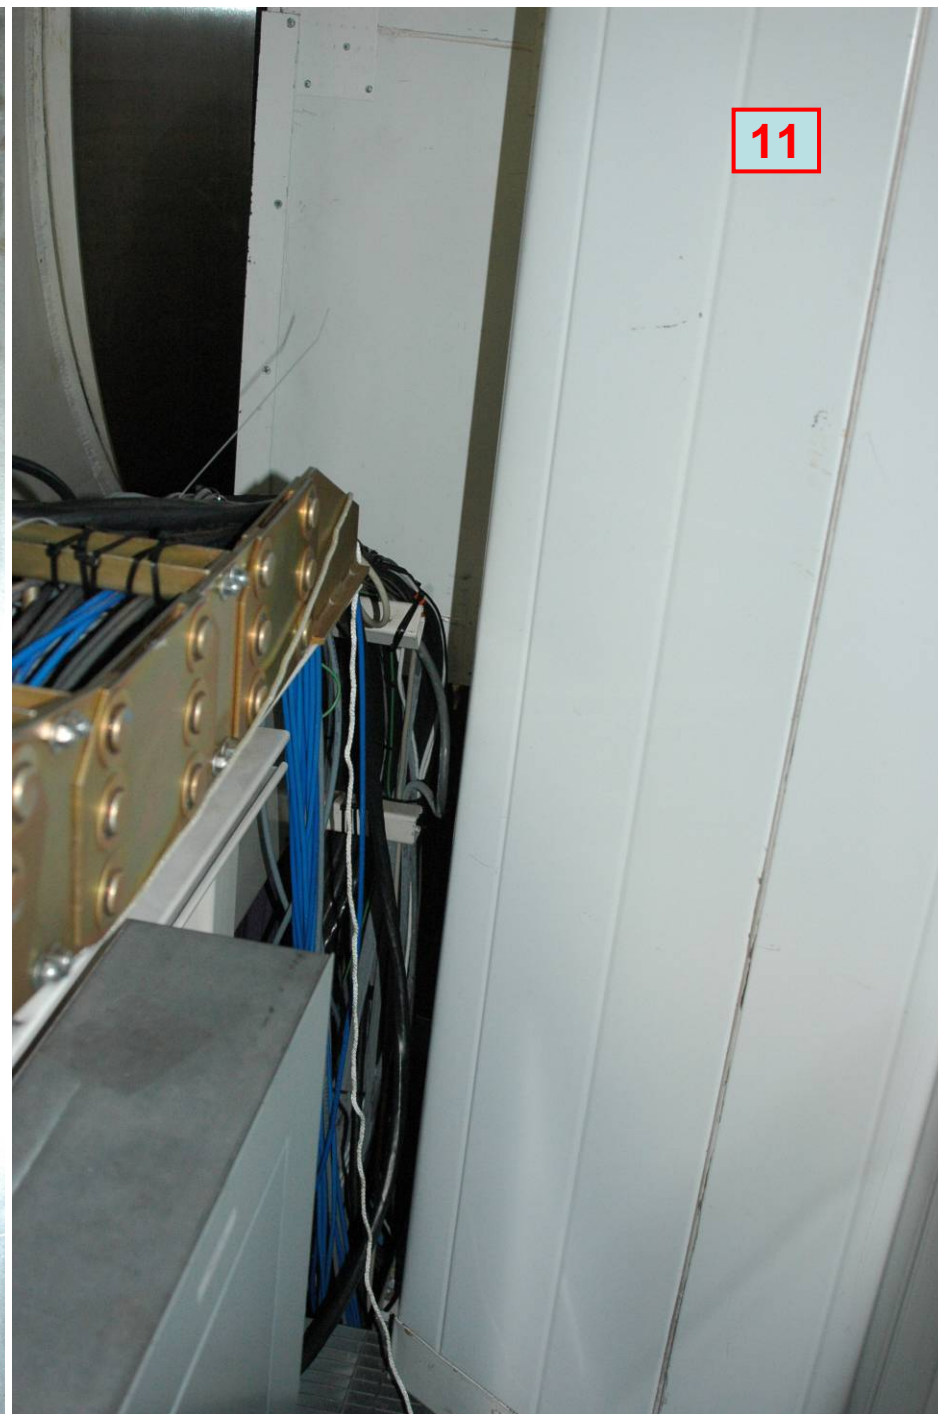

| REVISIONS | | | | |
|-----------|-----------|------------------------|-------|----------|
| REV | DATE | DESCRIPTION | ECR | APPROVED |
| A | 24 DEC 02 | UPDATED DRAWING NUMBER | 90989 | AC |

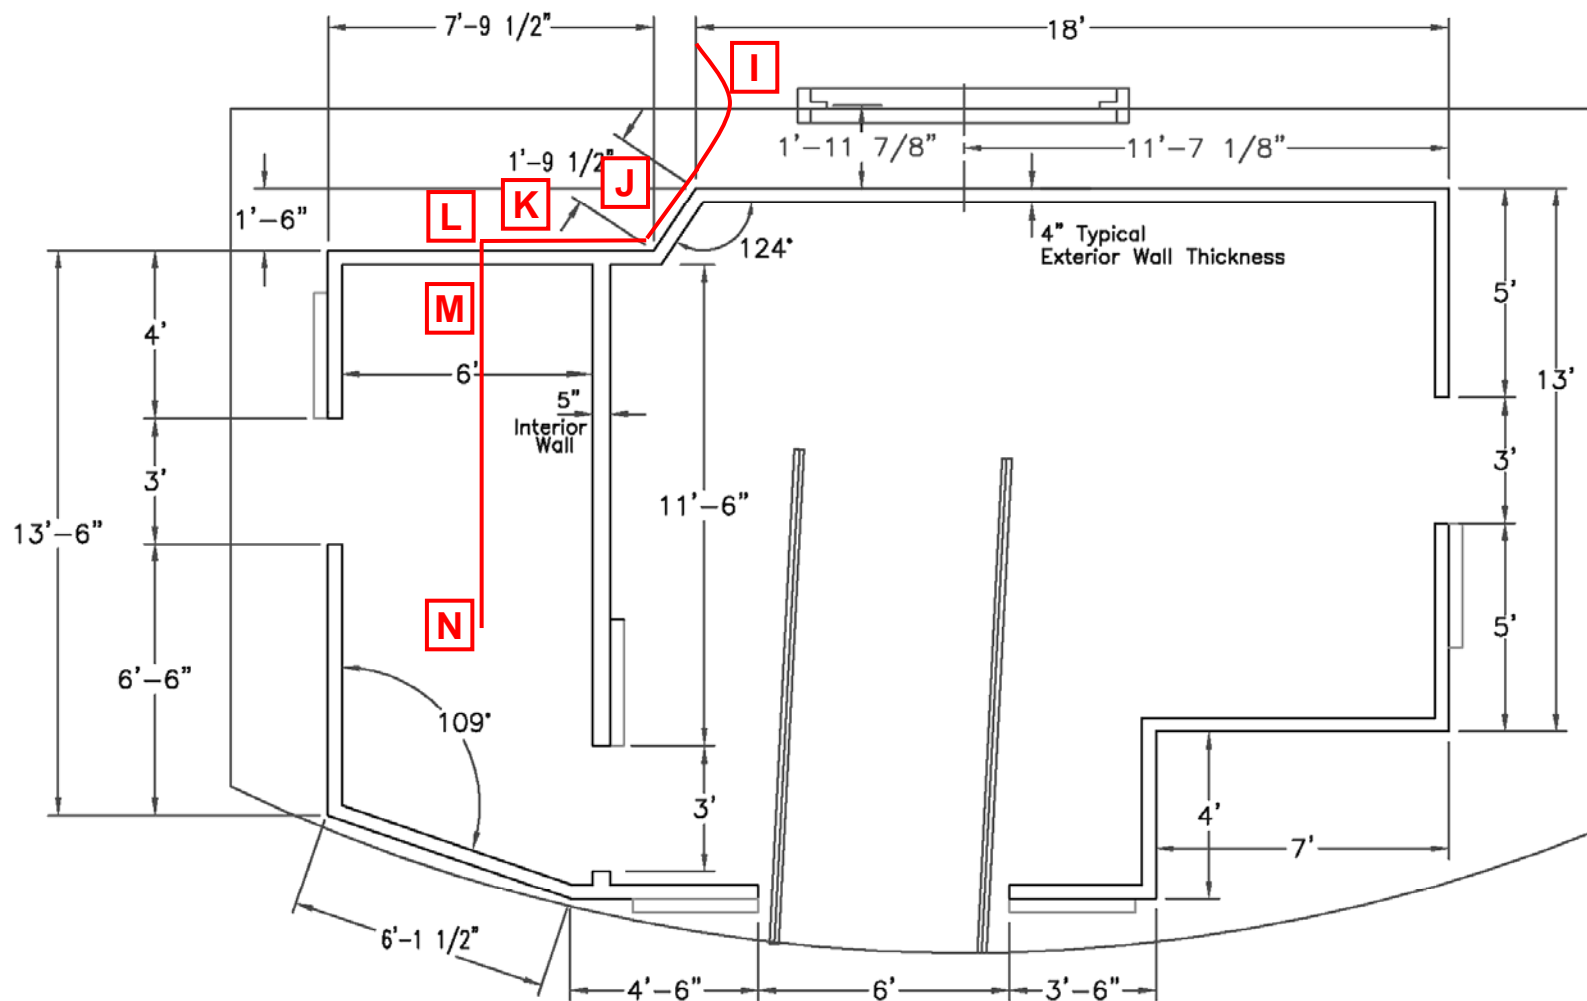

24 FEB 1997

| APPROVALS | DATE |
|-----------|------------|
| DESIGN | TG 1996-98 |
| DRAWN | KS 1998-98 |
| CONFIG'D | |
| CHECKED | |
| ENGR | |



W. M. KECK OBSERVATORY
California Association for Research in Astronomy

| SIZE | TITLE | DRAWING NUMBER | REV |
|------|------------------|----------------|-----|
| A | NASMYTH PLATFORM | 1300-C0008 | A |

